


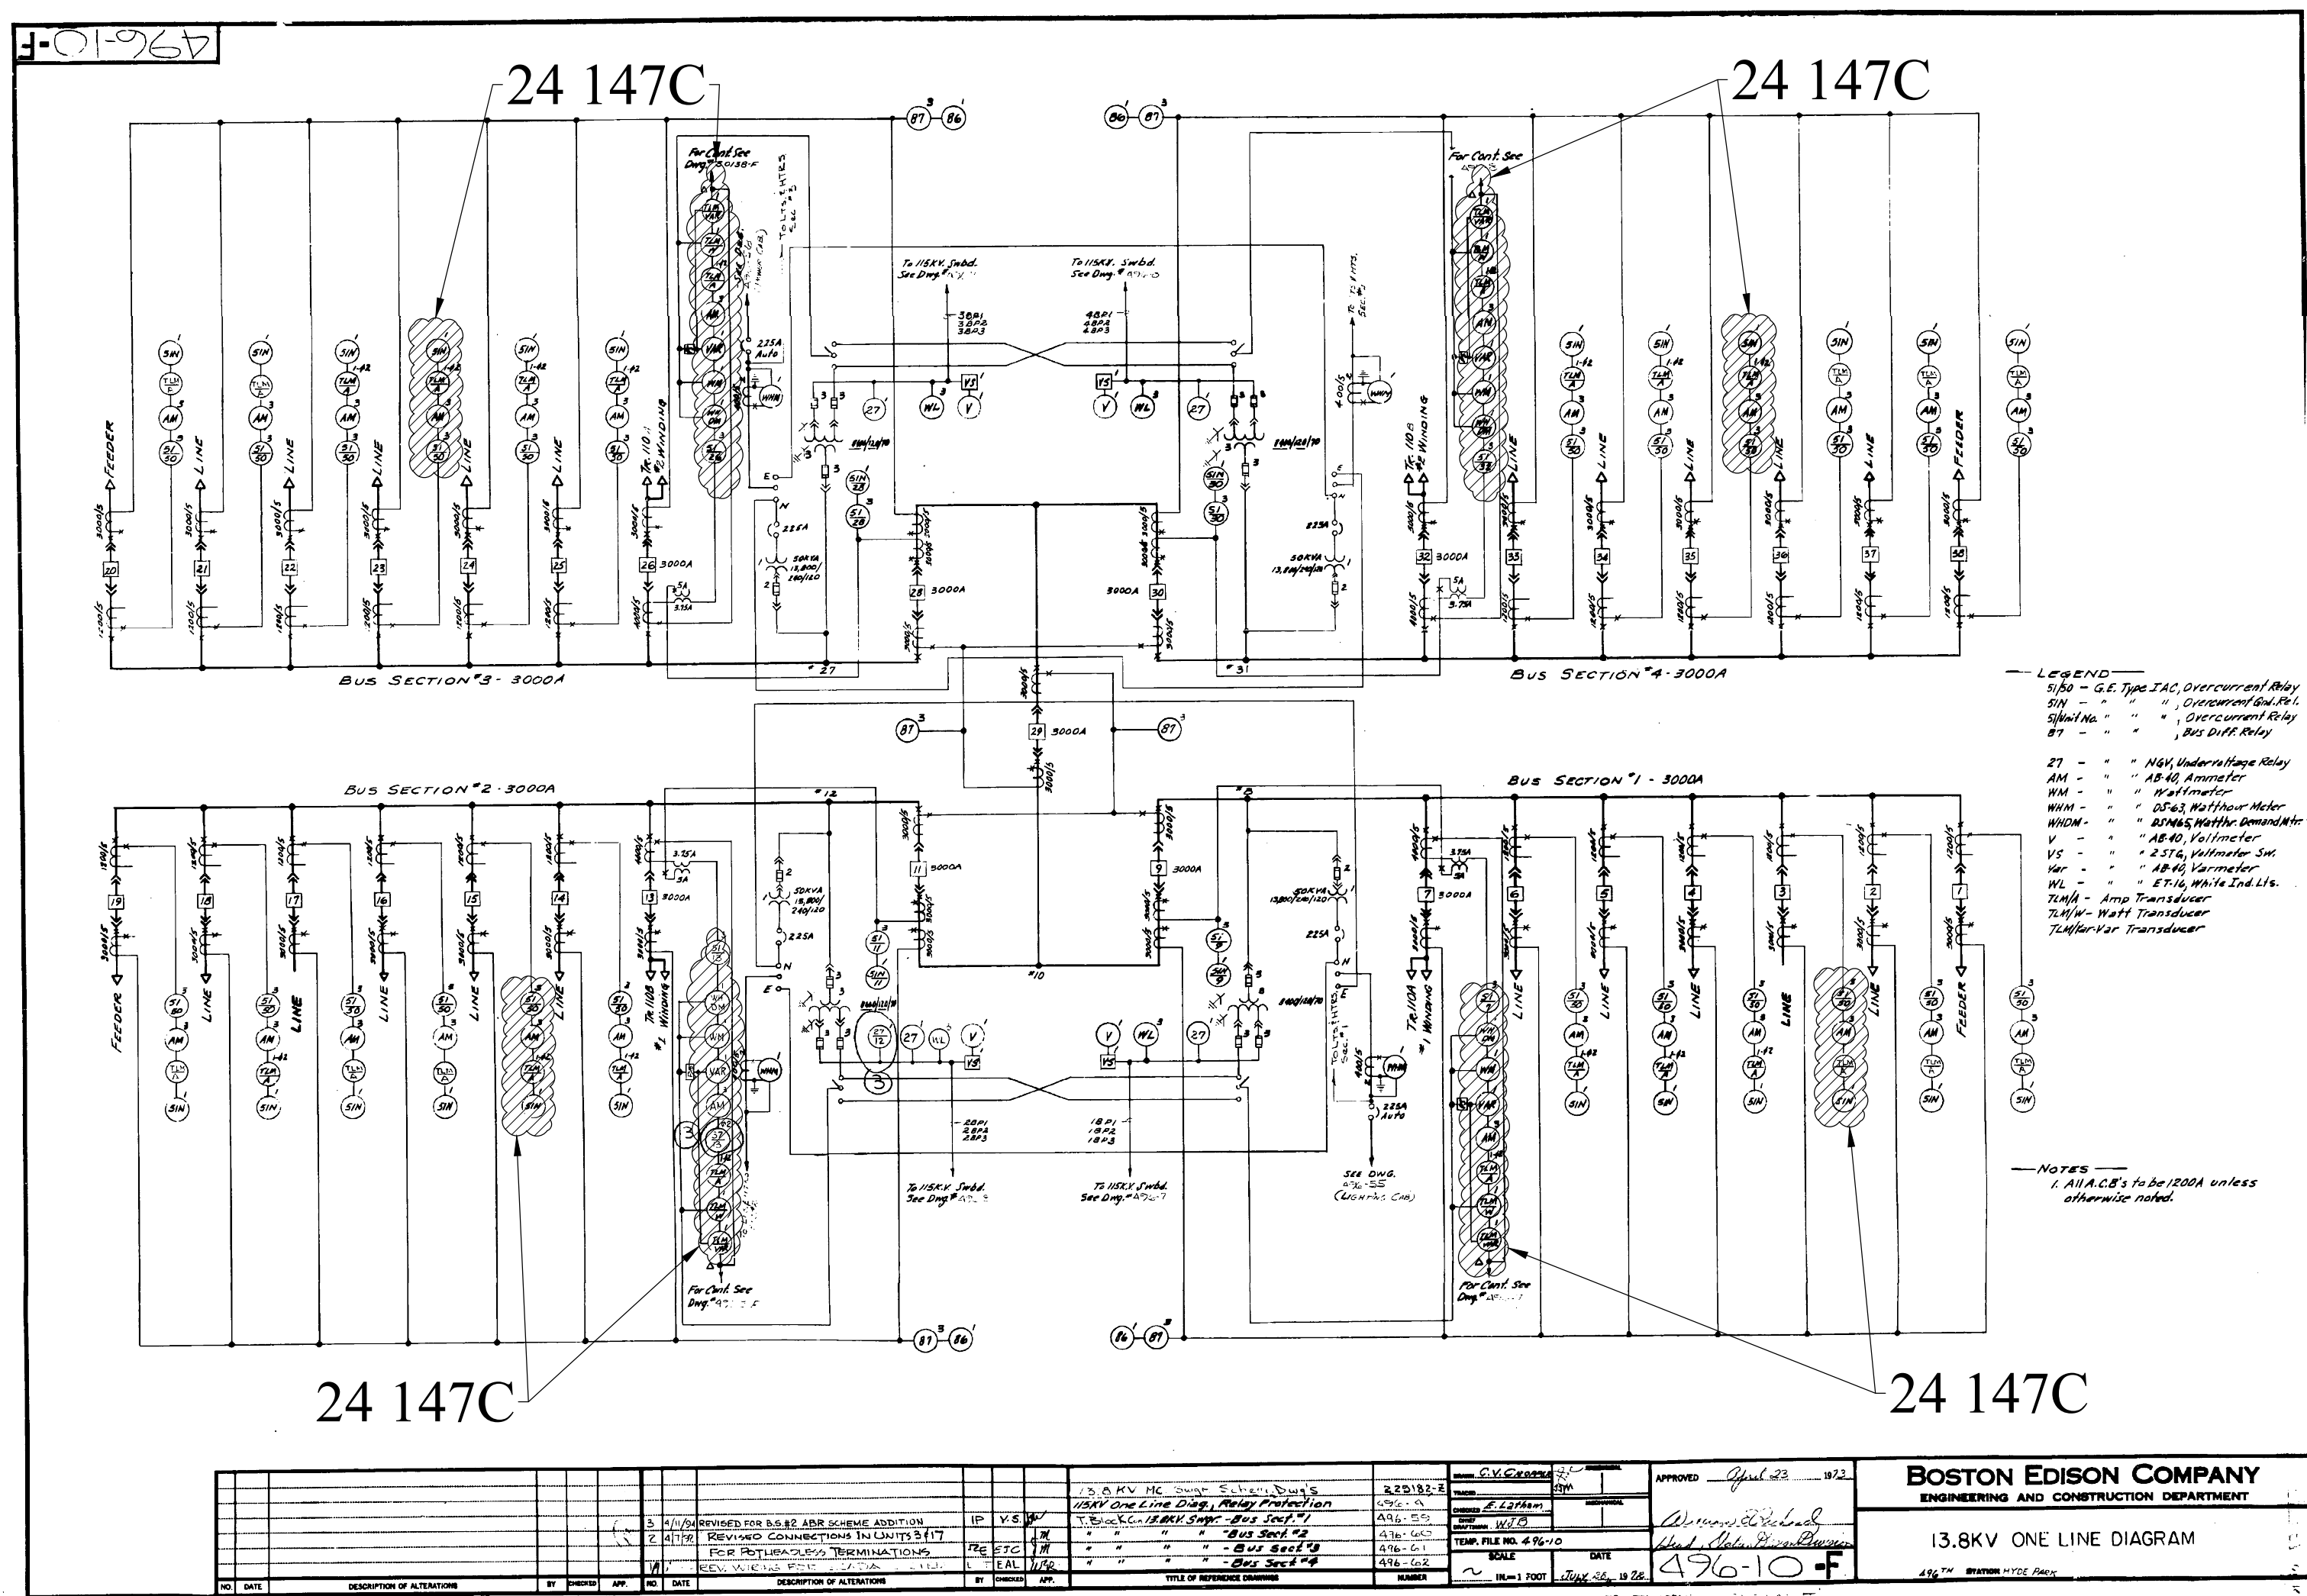

REVISIONS DURING CONSTRUCTION										EVERSOURCE ENERGY STATION 496 13.8KV ONE LINE DIAGRAM EA HYDE PARK <table><tr><td>BY</td><td colspan="3">DWG</td><td colspan="3">APP</td><td colspan="3">APP</td></tr><tr><td>DATE</td><td colspan="3">DATE</td><td colspan="3">DATE</td><td colspan="3">DATE</td></tr><tr><td colspan="3">V-SCALE</td><td colspan="3">V-SCALE</td><td colspan="3">STATION</td><td colspan="3">DATE</td></tr><tr><td colspan="3">SOURCE FILE</td><td colspan="3"></td><td colspan="3">DRAWING NO.</td><td colspan="3">496-10</td></tr></table>										BY	DWG			APP			APP			DATE	DATE			DATE			DATE			V-SCALE			V-SCALE			STATION			DATE			SOURCE FILE						DRAWING NO.			496-10		
BY	DWG			APP			APP																																																								
DATE	DATE			DATE			DATE																																																								
V-SCALE			V-SCALE			STATION			DATE																																																						
SOURCE FILE						DRAWING NO.			496-10																																																						
								*																																																							
AS BUILT REVISIONS										TITLE																																																					